A1F

DEVELOPER CONTRACT PLAN
WORK-AS-CONSTRUCTED

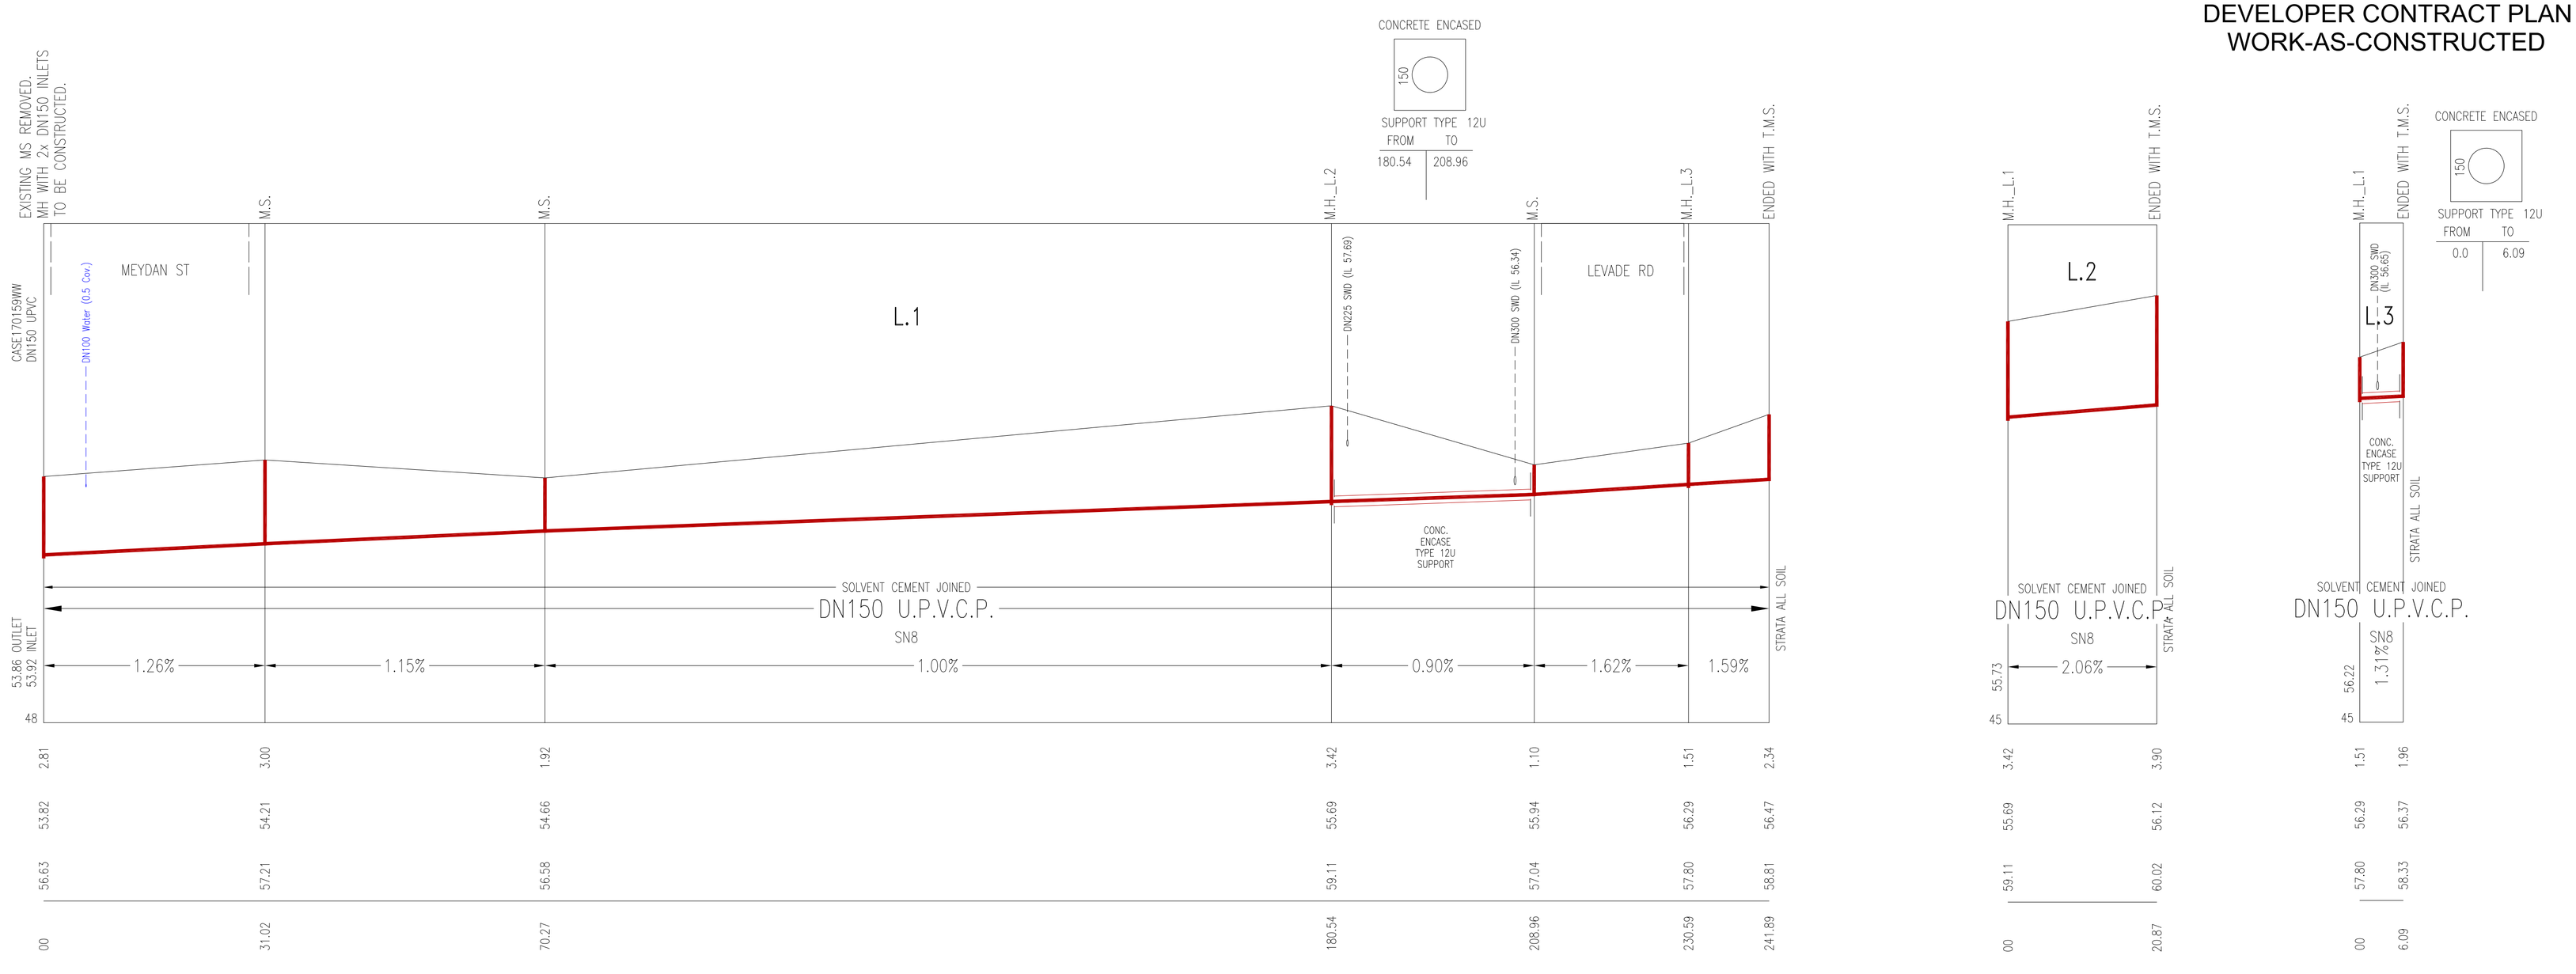

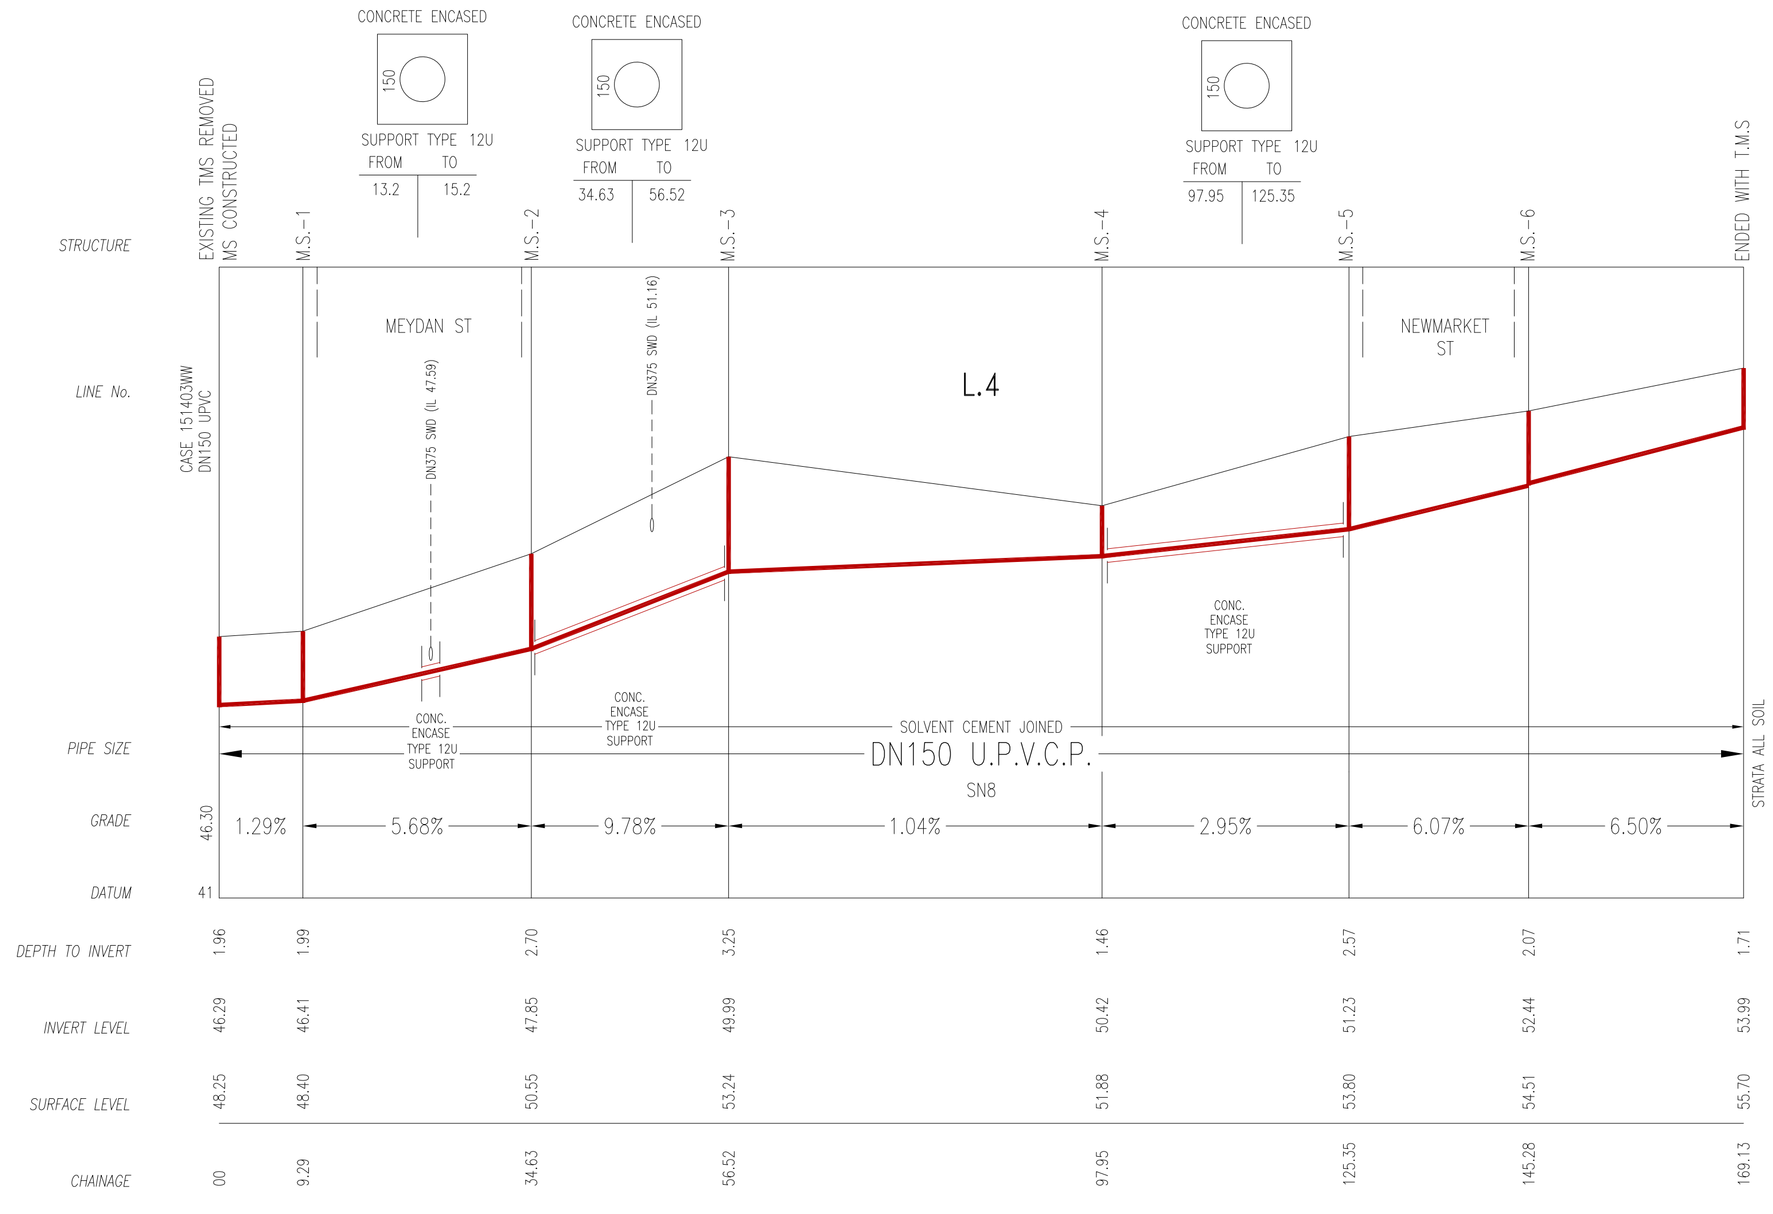

No.	AMENDMENT DESCRIPTION	BY	DATE
C	WORK AS CONSTRUCTED	J.L	12.07.21
B	LINE 4 AMENDED TO SUIT SITE CONDITION	BK	16.03.21
A	ISSUE FOR APPROVAL	J.L	12.11.20

WORK AS CONSTRUCTED CERTIFICATION

DEVELOPER LEGPRO 67 PTY LTD ATF LEGPRO 67 UNIT TR
W.S.C. OLSEN INFRASTRUCTURE PTY LTD
CONSTRUCTOR CJ DOYLE CONTRACTING
COMPLETED 08.04.21
W.A.C. PREPARED 12.07.21

DESIGNER OLSEN INFRASTRUCTURE PTY LTD

I CERTIFY THAT THE WORKS HAVE BEEN CONSTRUCTED IN ACCORDANCE WITH THE WORK AS CONSTRUCTED DRAWINGS

SYDNEY WATER CORPORATION

Case No. 187692WW | SHT 2 OF 2 SHTS.

SYDNEY WATER CORPORATION

FOR DETAILS OF SERVICES SEE SHEET 1

PLAN DRAWN DATE: 12.07.21 VERSION: C SHEET 2 OF 2 SHEETS